



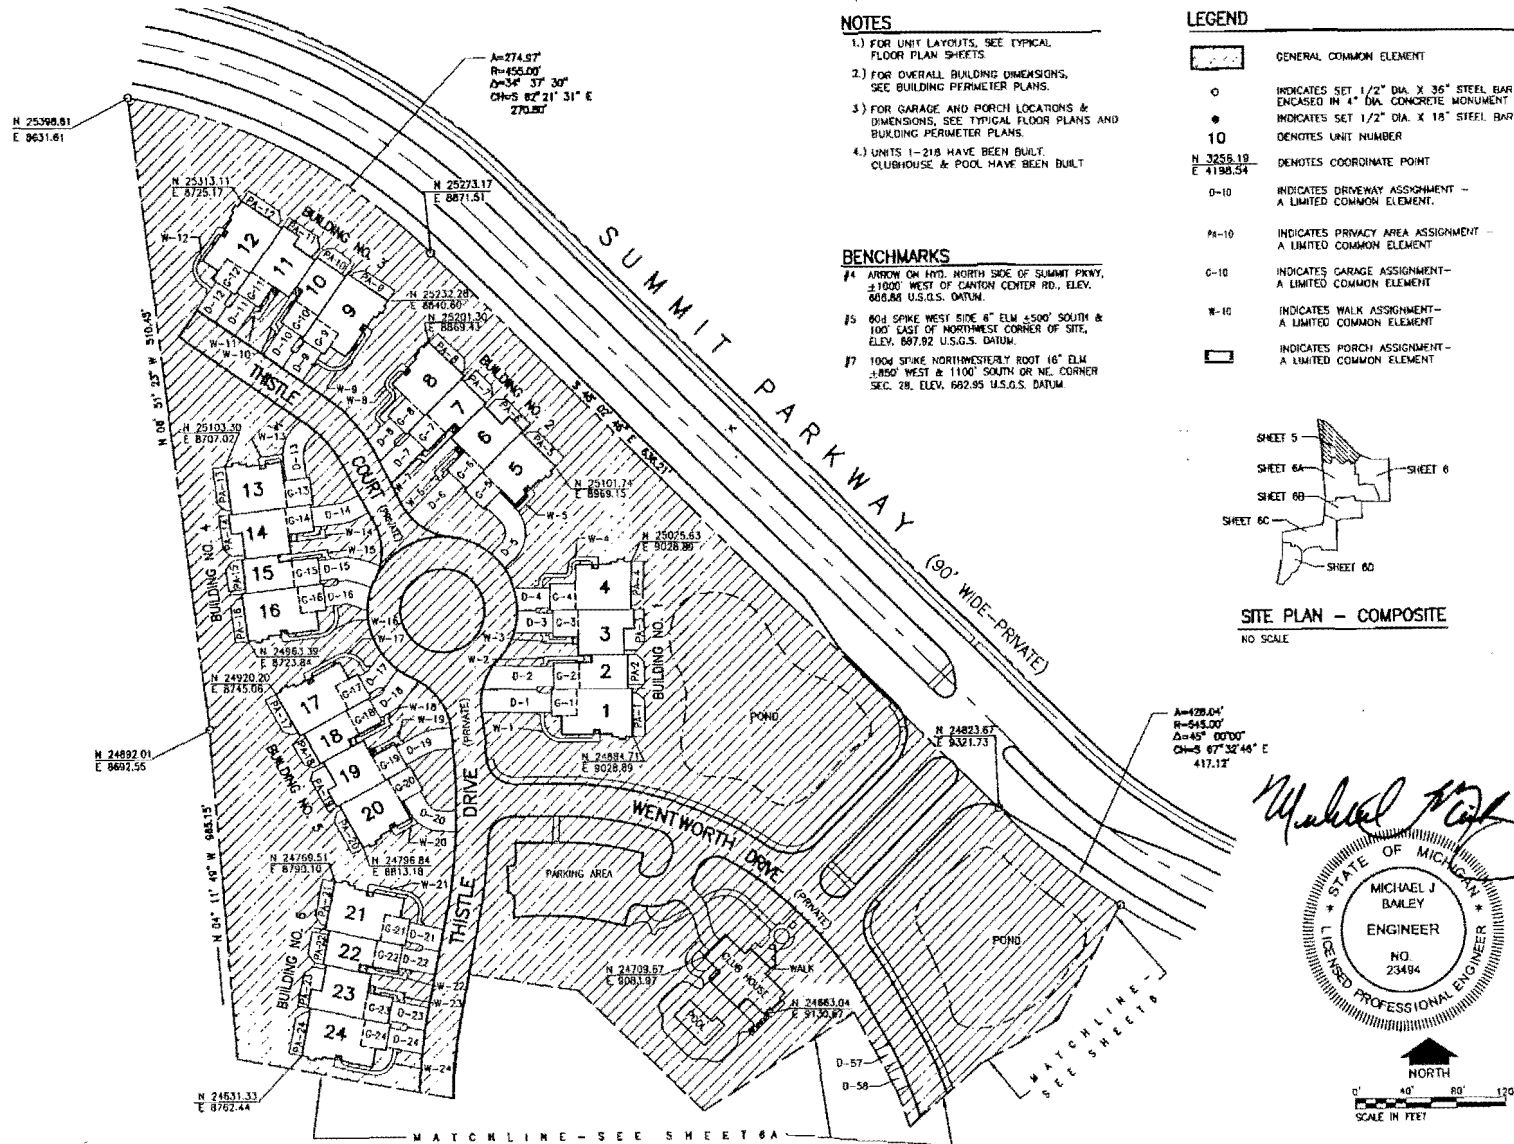


Pa-135

Li-40293

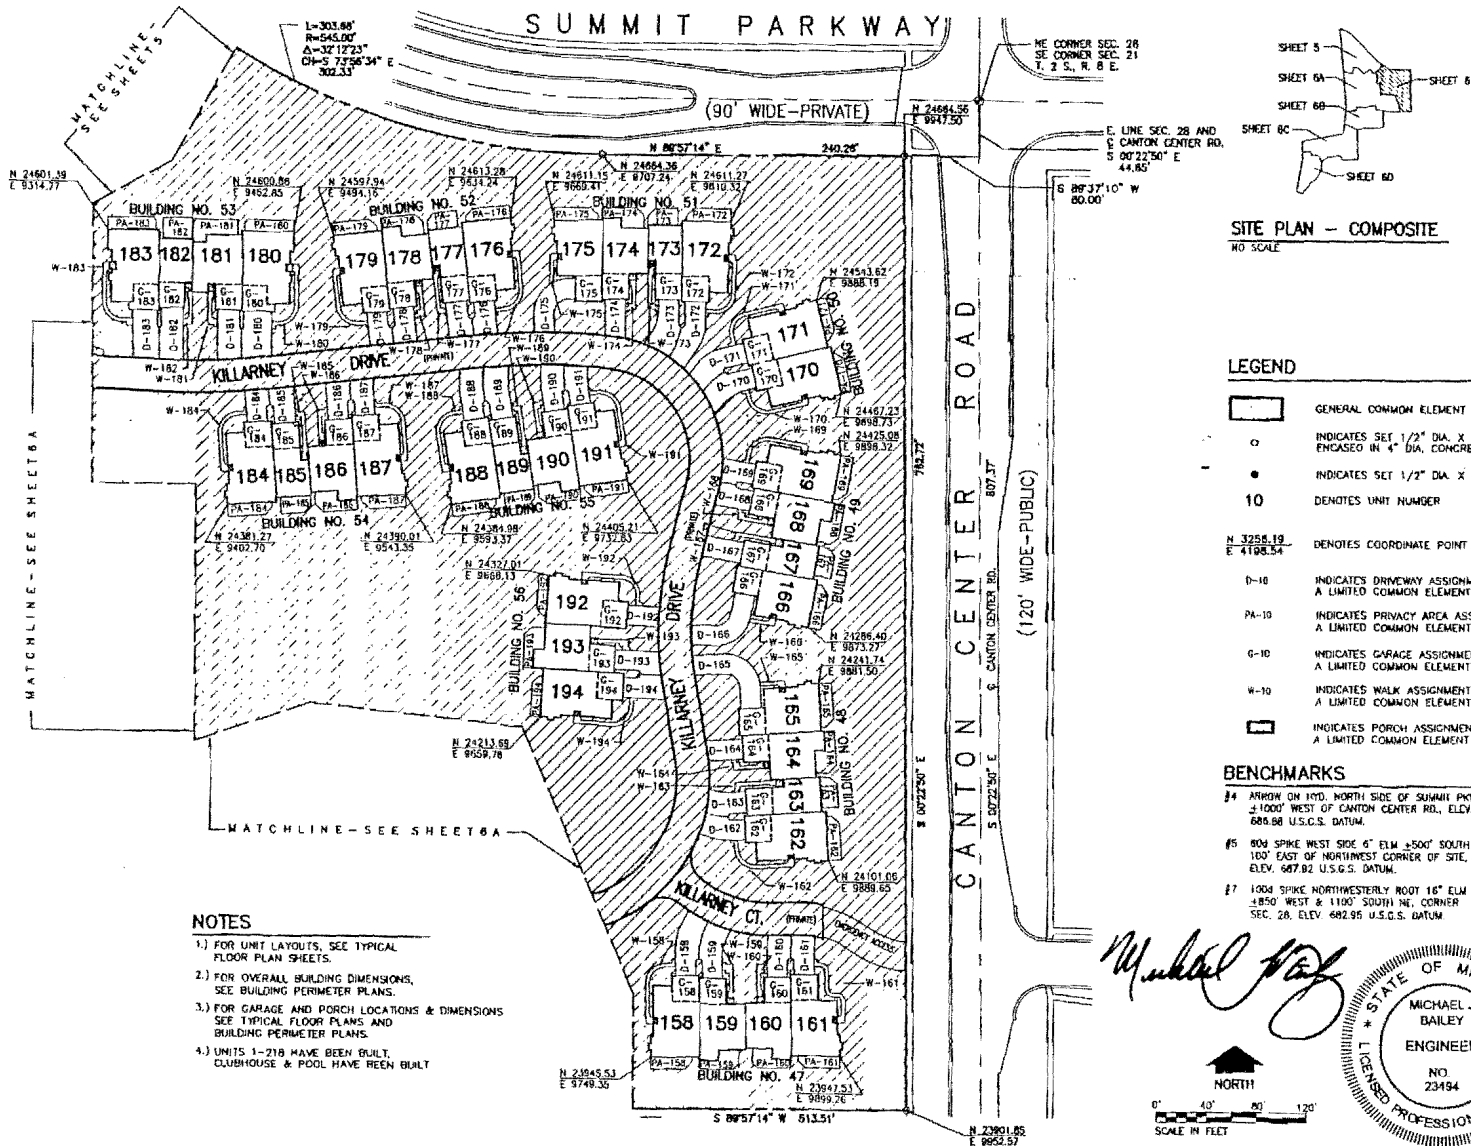

LI-40293

PLEASANT RUN GOLF COURSE

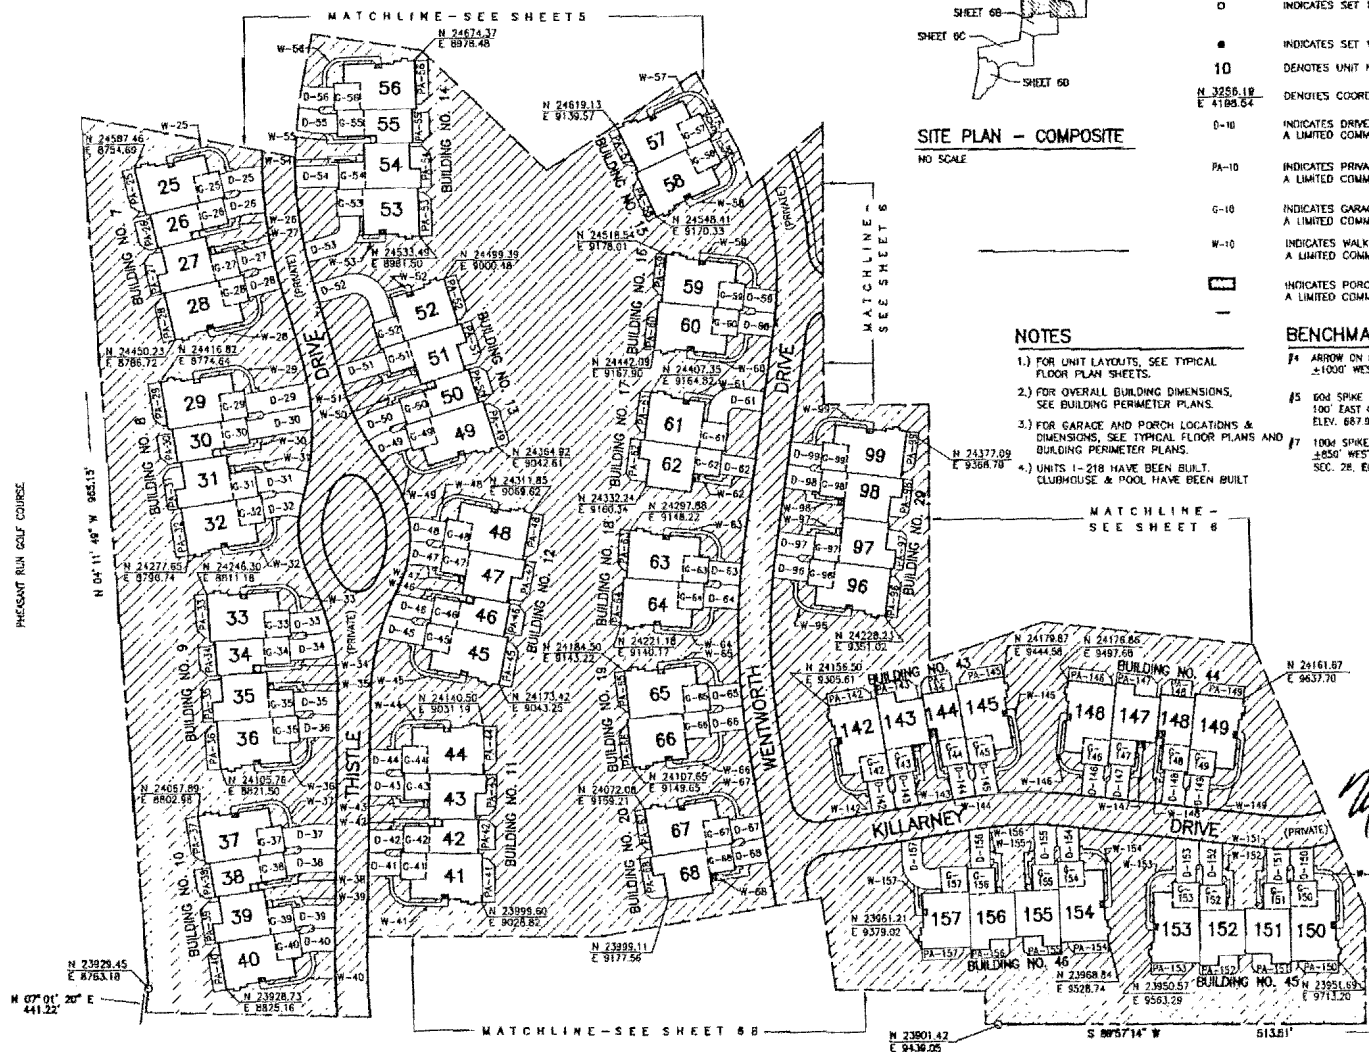


	GENERAL COMMON ELEMENT
	INDICATES SET 1/2" DIA. X 3/8" STEEL BAR
	INDICATES SET 1/2" DIA. X 1/8" STEEL BAR
10	DENOTES UNIT NUMBER
N 3255.19 E 4185.04	DENOTES COORDINATE POINT
D-10	INDICATES DRIVEWAY ASSIGNMENT -- A LIMITED COMMON ELEMENT.
PA-10	INDICATES PRIVACY AREA ASSIGNMENT -- A LIMITED COMMON ELEMENT
G-10	INDICATES GARAGE ASSIGNMENT-- A LIMITED COMMON ELEMENT
W-10	INDICATES WALK ASSIGNMENT-- A LIMITED COMMON ELEMENT
	INDICATES PORCH ASSIGNMENT -- A LIMITED COMMON ELEMENT

14 ARROW ON HYD. NORTH SIDE OF SUMMIT PKWY.
±1000' WEST OF CANTON CENTER RD., ELEV

15 600 SPIKE WEST SIDE 8" ELM ±500' SOUTH &
100' EAST OF NORTHWEST CORNER OF SITE.
ELEV. 687.92 U.S.G.S. DATUM.

16 1000 SPIKE NORTHWESTERLY FOOT 16" ELM
±850' WEST & 1100' SOUTH NE CORNER
SFC. 20. ELEV. 682.95 U.S.G.S. DATUM.

- 1.) FOR UNIT LAYOUTS, SEE TYPICAL FLOOR PLAN SHEETS.
- 2.) FOR OVERALL BUILDING DIMENSIONS, SEE BUILDING PERIMETER PLANS.
- 3.) FOR GARAGE AND PORCH LOCATIONS & DIMENSIONS, SEE TYPICAL FLOOR PLANS BUILDING PERIMETER PLANS.
- 4.) UNITS 1-218 HAVE BEEN BUILT. CLUBHOUSE & POOL HAVE BEEN BUILT

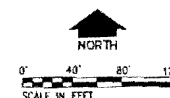


AS BUILT DATE: MAY 17, 2000

DIETRICH, BAILEY AND ASSOCIATES, P.C.
107 South Main Street Plymouth, Michigan 48170
734/455-3111 FAX 734/455-3127

SITE PLAN
LINKS OF PHEASANT RUN CONDOMINIUM
SECTION 21 & 28, CANTON TOWNSHIP, WAYNE COUNTY, MICHIGAN

6A

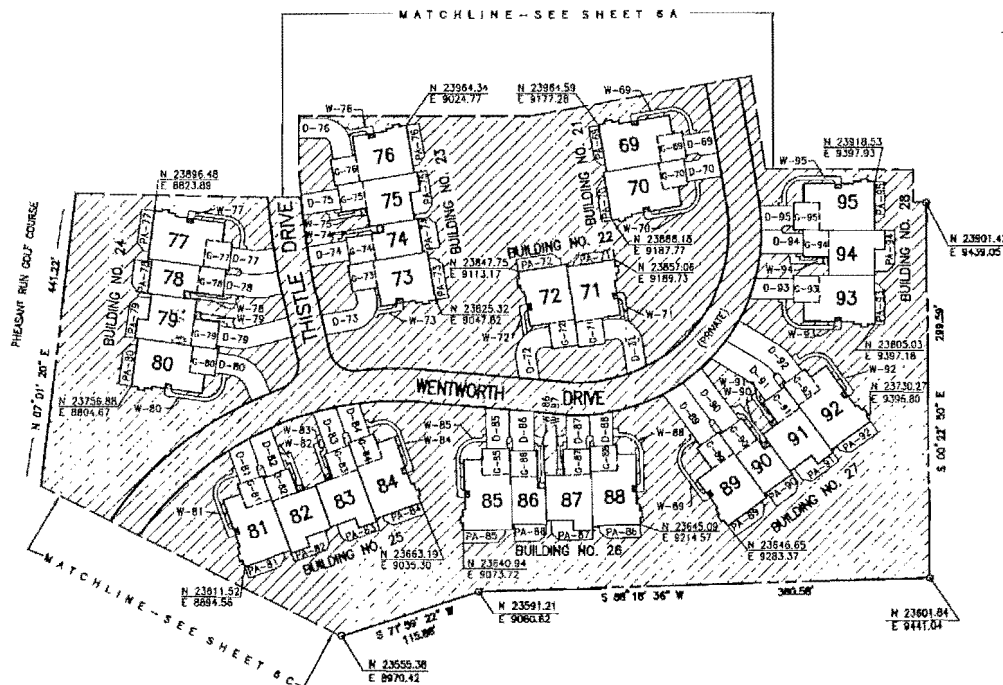

LEGEND



- GENERAL COMMON ELEMENT
- INDICATES SET 1/2" DIA. X 36" STEEL BAR ENCASED IN 4" DIA. CONCRETE MONUMENT
- INDICATES SET 1/2" DIA. X 18" STEEL BAR
- 10** DENOTES UNIT NUMBER
- DENOTES COORDINATE POINT
- INDICATES DRIVEWAY ASSIGNMENT - A LIMITED COMMON ELEMENT.
- INDICATES PRIVACY AREA ASSIGNMENT - A LIMITED COMMON ELEMENT
- INDICATES GARAGE ASSIGNMENT - A LIMITED COMMON ELEMENT
- INDICATES WALK ASSIGNMENT - A LIMITED COMMON ELEMENT
- INDICATES PORCH ASSIGNMENT - A LIMITED COMMON ELEMENT

NOTES

- 1.) FOR UNIT LAYOUTS, SEE TYPICAL FLOOR PLAN SHEETS.
- 2.) FOR OVERALL BUILDING DIMENSIONS, SEE BUILDING PERIMETER PLANS.
- 3.) FOR GARAGE AND PORCH LOCATIONS & DIMENSIONS, SEE TYPICAL FLOOR PLANS AND BUILDING PERIMETER PLANS.
- 4.) UNITS 1-219 HAVE BEEN BUILT. CLUBHOUSE & POOL HAVE BEEN BUILT.

BENCHMARKS

14. ARROW ON HYD. NORTH SIDE OF SUMMIT PKWY. ±1000' WEST OF CANTON CENTER RD., ELEV. 686.66 U.S.G.S. DATUM.
15. 604 SPIKE WEST SIDE 6" D.M. ±500' SOUTH & 100' EAST OF NORTHWEST CORNER OF SITE, ELEV. 687.92 U.S.G.S. DATUM.
17. 1004 SPIKE NORTHWESTERLY FOOT 16" D.M. ±850' WEST & 1100' SOUTH NE CORNER SEC. 28, ELEV. 682.95 U.S.G.S. DATUM.

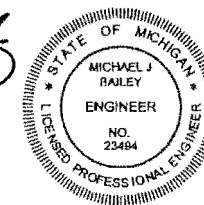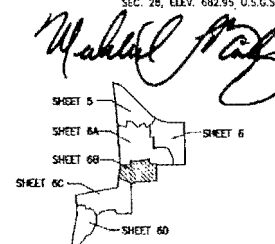

SITE PLAN -- COMPOSITE
NO SCALE



AS BUILT DATE: MAY 17, 2000

DBA DIETRICH, BAILEY AND ASSOCIATES, P.C.
107 South Main Street Plymouth, Michigan 48170
734/455-3127 FAX 734/455-3127

SITE PLAN
LINKS OF PHEASANT RUN CONDOMINIUM
SECTION 21 & 28, CANTON TOWNSHIP, WAYNE COUNTY, MICHIGAN

Pa-138

LI-40293

LEGEND

	GENERAL COMMON ELEMENT	D-10	INDICATES DRIVEWAY ASSIGNMENT - A LIMITED COMMON ELEMENT
	INDICATES SET 1/2" DIA X 36" STEEL BAR ENCASED IN 4" DIA CONCRETE MONUMENT	PA-10	INDICATES PRIVACY AREA ASSIGNMENT - A LIMITED COMMON ELEMENT
	INDICATES SET 1/2" DIA X 18" STEEL BAR	G-10	INDICATES GARAGE ASSIGNMENT - A LIMITED COMMON ELEMENT
10	DENOTES UNIT NUMBER	W-10	INDICATES WALK ASSIGNMENT - A LIMITED COMMON ELEMENT
N 3258.19 E 4196.54	DENOTES COORDINATE POINT		INDICATES PORCH ASSIGNMENT - A LIMITED COMMON ELEMENT

BENCHMARKS



- #4 ARROW ON HYD. NORTH SIDE OF SUMMIT PKWY. ±1000' WEST OF CANTON CENTER RD., ELEV. 686.89 U.S.G.S. DATUM.
- #5 606 SPIKE WEST SIDE E" ELM ±500' SOUTH & 100' EAST OF NORTHWEST CORNER OF SITE, ELEV. 687.92 U.S.G.S. DATUM.
- #7 1006 SPIKE NORTHWESTERLY 100' 16" ELM ±850' WEST & 1100' SOUTH NE CORNER SEC. 28, ELEV. 682.95 U.S.G.S. DATUM.

NOTES



- 1.) FOR UNIT LAYOUTS, SEE TYPICAL FLOOR PLAN SHEETS.
- 2.) FOR OVERALL BUILDING DIMENSIONS, SEE BUILDING PERIMETER PLANS.
- 3.) FOR GARAGE AND PORCH LOCATIONS & DIMENSIONS, SEE TYPICAL FLOOR PLANS AND BUILDING PERIMETER PLANS.
- 4.) UNITS 1-218 HAVE BEEN BUILT. CLUBHOUSE & POOL HAVE BEEN BUILT.

SITE PLAN - COMPOSITE

NO SCALE

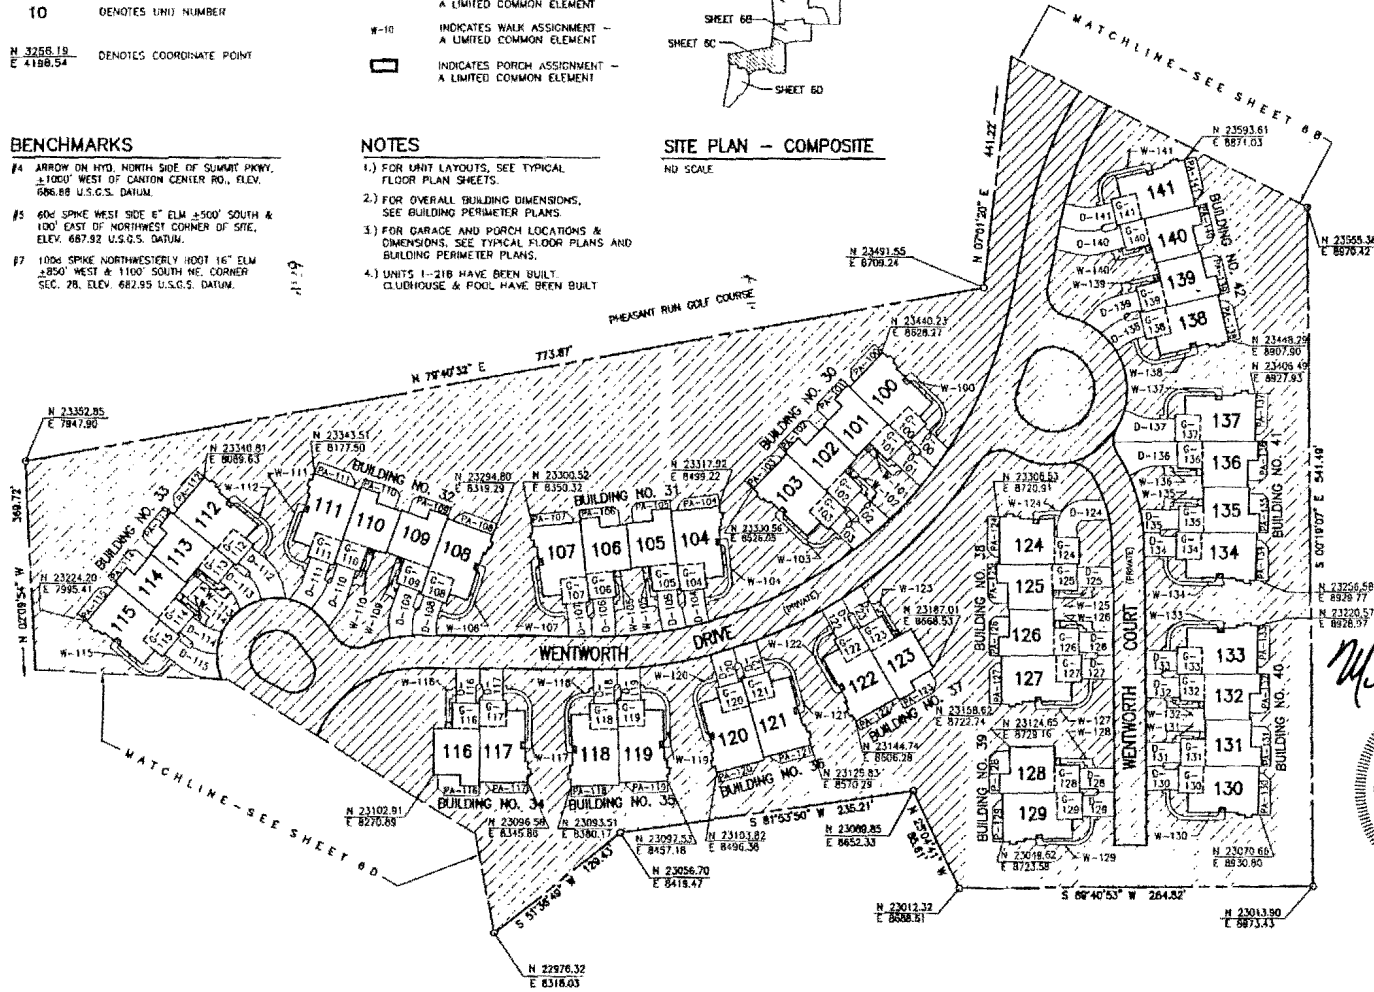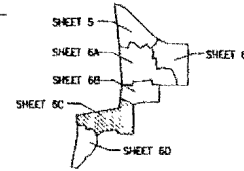

Michael J. Bailey

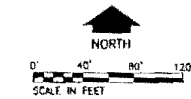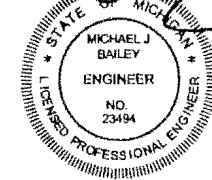


AS BUILT DATE: MAY 17, 2000

DIETRICH, BAILEY AND ASSOCIATES, P.C.
107 South Main Street Plymouth, Michigan 48170
734/455-3111 FAX 734/455-3127

DBA

SITE PLAN
LINKS OF PHEASANT RUN CONDOMINIUM
SECTION 21 & 28, CANTON TOWNSHIP, WAYNE COUNTY, MICHIGAN



6C

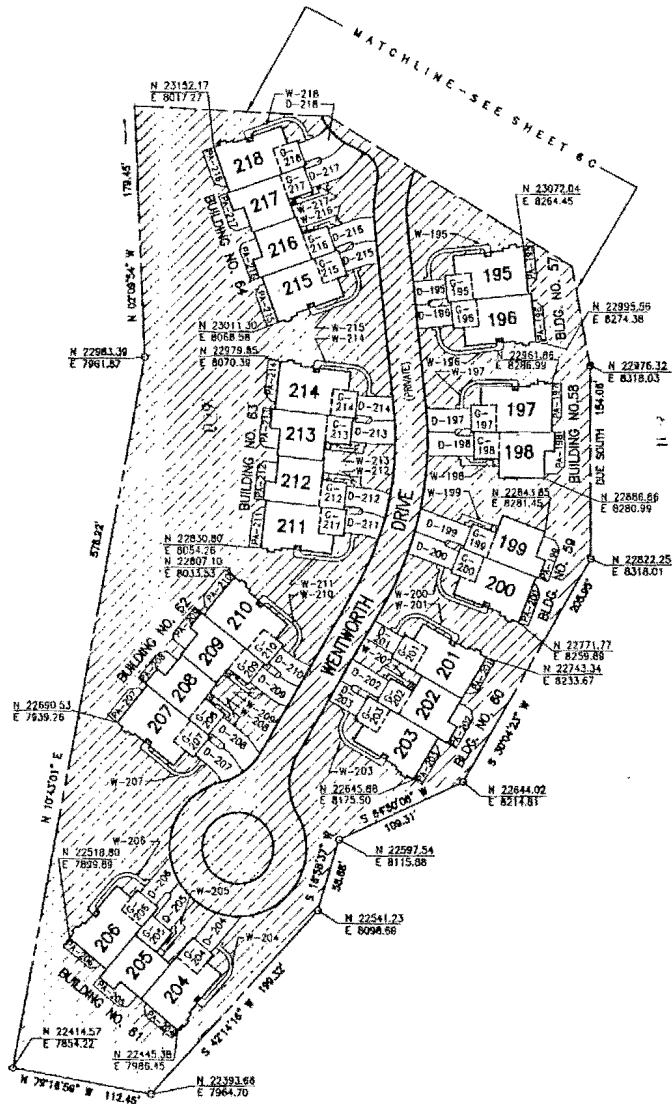

NOTES

- 1.) FOR UNIT LAYOUTS, SEE TYPICAL FLOOR PLAN SHEETS.
- 2.) FOR OVERALL BUILDING DIMENSIONS, SEE BUILDING PERIMETER PLANS.
- 3.) FOR GARAGE AND PORCH LOCATIONS, SEE TYPICAL FLOOR PLANS AND BUILDING PERIMETER PLANS.
- 4.) UNITS 1-218 HAVE BEEN BUILT. CLUBHOUSE & POOL HAVE BEEN BUILT.

Michael J. Bailey

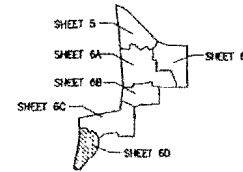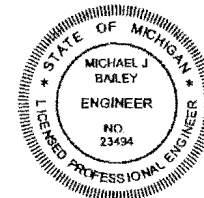

SITE PLAN - COMPOSITE


NO SCALE

LEGEND

- GENERAL COMMON ELEMENT
- INDICATES SET 1/2" DIA. X 36" STEEL BAR ENCASED IN 4" DIA. CONCRETE MONUMENT
- INDICATES SET 1/2" DIA. X 18" STEEL BAR
- 10** DENOTES UNIT NUMBER
- DENOTES COORDINATE POINT
- D-10** INDICATES DRIVEWAY ASSIGNMENT - A LIMITED COMMON ELEMENT.
- PA-10** INDICATES PRIVACY AREA ASSIGNMENT - A LIMITED COMMON ELEMENT
- G-10** INDICATES GARAGE ASSIGNMENT - A LIMITED COMMON ELEMENT
- W-10** INDICATES WALK ASSIGNMENT - A LIMITED COMMON ELEMENT
- INDICATES PORCH ASSIGNMENT - A LIMITED COMMON ELEMENT

BENCHMARKS

- #4 ARROW ON 110' NORTH SIDE OF SUMMIT PKWY, ±1000' WEST OF CANTON CENTER RD., ELEV. 688.88 U.S.G.S. DATUM.
- #5 608 SPIKE WEST SIDE 6" ELM ±500' SOUTH & 100' EAST OF NORTHWEST CORNER OF SITE, ELEV. 687.92 U.S.G.S. DATUM.
- #7 1004 SPIKE NORTHWESTERLY ROOT 16" ELM ±850' WEST & 1100' SOUTH NE CORNER SEC. 28, ELEV. 682.95 U.S.G.S. DATUM.

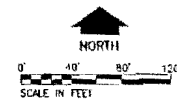

AS BUILT DATE: MAY 17, 2000

DIETRICH, BAILEY AND ASSOCIATES, P.C.
Plymouth, Michigan 48179
107 South Main Street
FAX 734/455-3127

DBA

SITE PLAN
LINKS OF PHEASANT RUN CONDOMINIUM
SECTION 21 & 28, CANTON TOWNSHIP, WAYNE COUNTY, MICHIGAN